TORONTO Building

PERMIT REVIEWED FOR COMPLIANCE WITH THE ONTARIO BUILDING CODE

26 206274 BLD 00

ZONING		
O.B.C.	Shah, Sahil	26/Jul/2026
FIRE SERVICES		

O.B.C. (S)


Where the permit drawings and/or documents bear the seal of a professional engineer, no independent review was carried out by Toronto Building to confirm that the matters to which the seal relates comply with the Ontario Building Code. As the seal denotes assumption of responsibility by the professional engineer, compliance with the Ontario Building Code was determined by reasonably relying solely on the seal of the professional engineer.

The City has relied upon the plans and drawings prepared and submitted by the owner and his designers on this project. The issuance of a permit does not relieve the owner and designers from the need to comply with the Building Code and referenced standards where contravention is subsequently noted.

LICENSED PROFESSIONAL ENGINEER — M. F. PARENTE — 100517923 — July 09, 2026 — PROVINCE OF ONTARIO

STRUCTURAL INFO ONLY

PALMVIEW CUSTOM HOMES

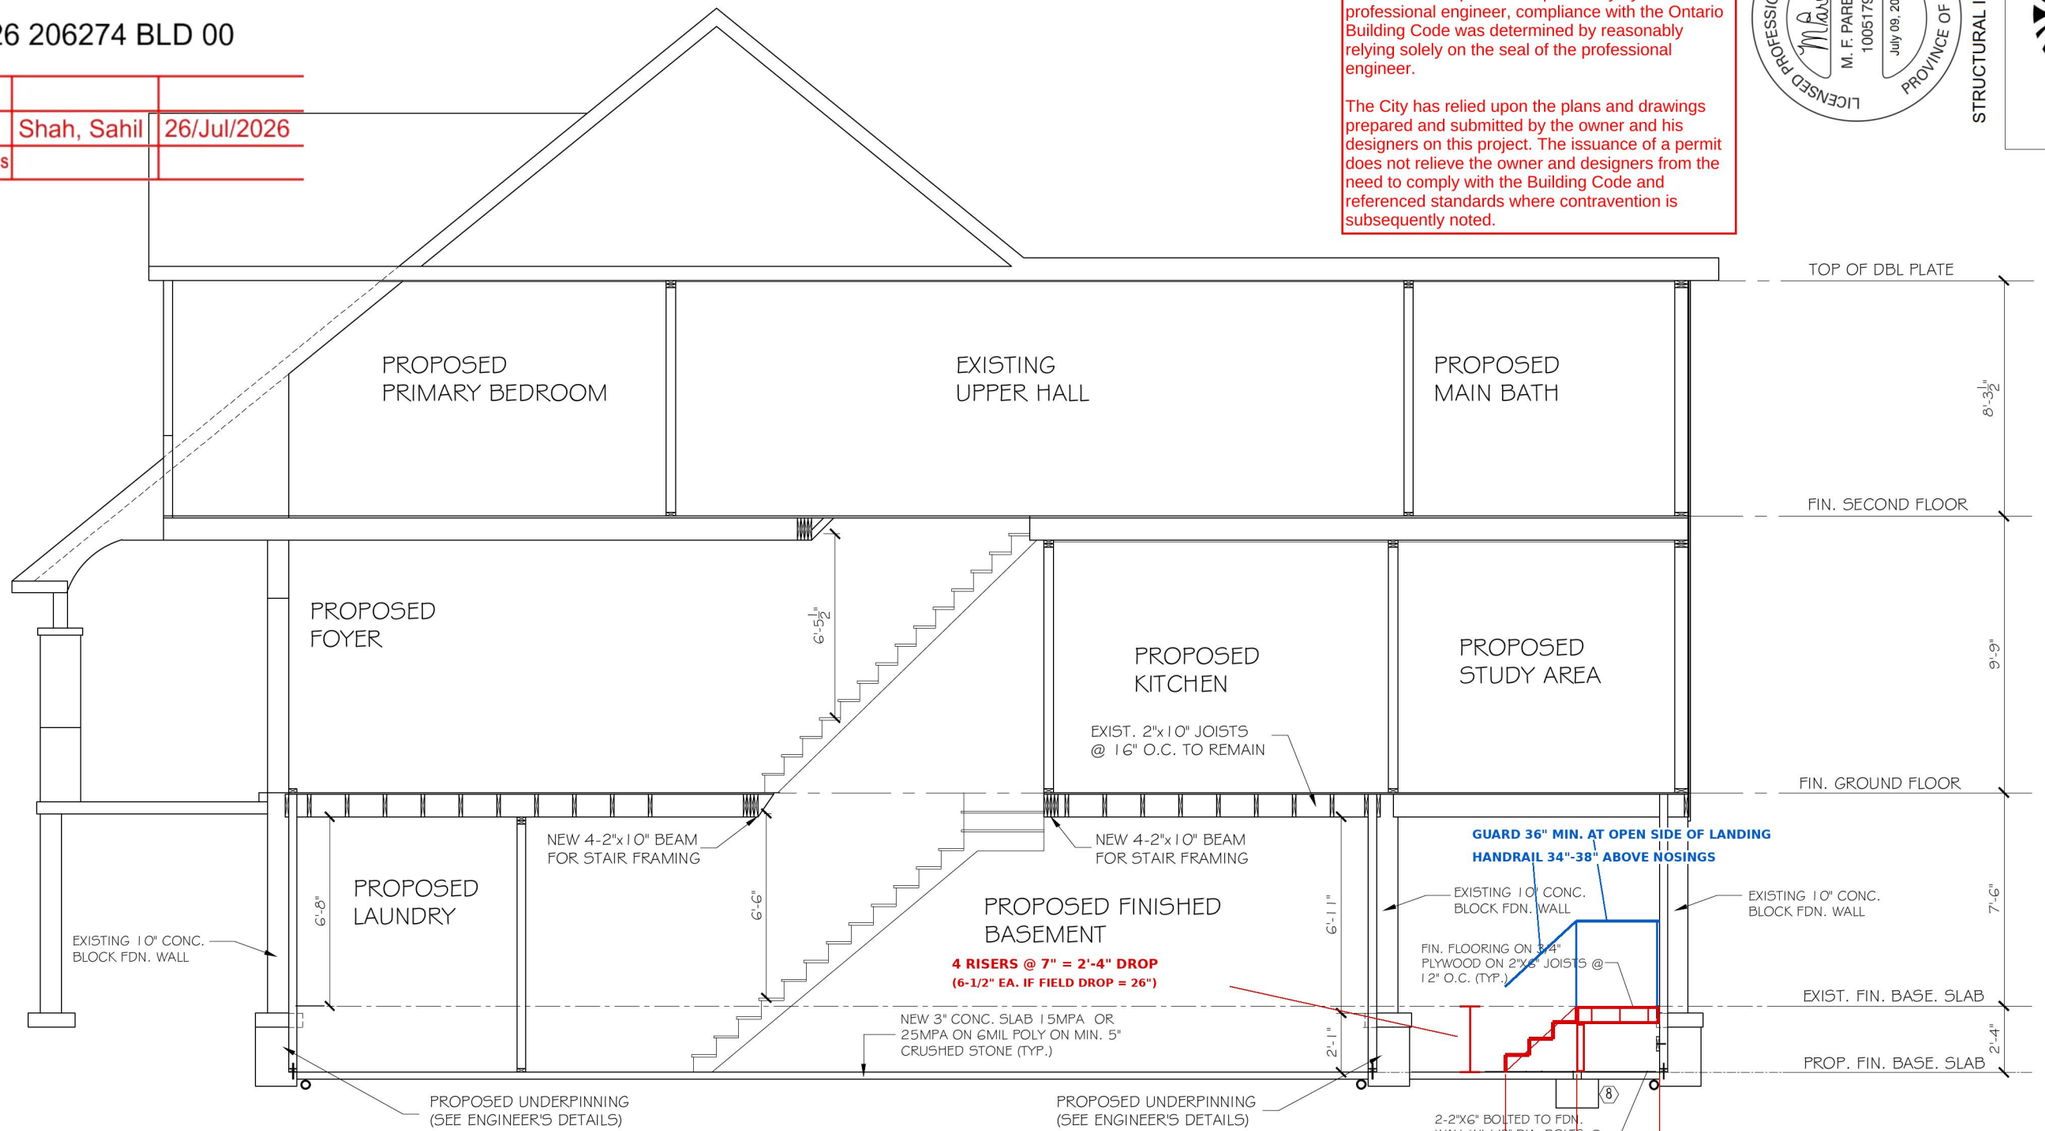

CROSS SECTION A-A

SCALE : 3/16" = 1'-0"

PALMVIEW MARKUP - REAR ENTRY STAIR (21)
Landing at exist. door sill / exist. slab elev.; 2x6 @ 12" o.c.
4 risers: 7" @ 2'-4" drop (6-1/2" if field drop is 26")
3 treads @ 10" run (min. 8-1/4" run / 9-1/4" tread per OBC)
Bottom step lands ~5'-5" from rear wall into games room
Drawn 3R / 2T stair = 9"+ rise -> exceeds 7-7/8" max. REVISE.
Guard req'd: landing > 600mm above floor. Width 3'-5" OK.
Verify sill-to-finished-floor in field before framing.

The undersigned has reviewed and takes responsibility for the design, and has the qualifications and meets the requirements set out in the Ontario Building Code to be designer.

QUALIFICATION INFORMATION
Required unless design is exempt under Division C–3.2.5.1. of the 2006 Ontario Building Code

Pino Lavecchia		38258
NAME	SIGNATURE	BCIN
LA VECCHIA DESIGNS	FIRM BCIN	40709

Drawing No. A9/A10

1348 OGDEN AVENUE
MISSISSAUGA, ON, L5E 2H8
(416)206-9749
plve@rogers.com

LA VECCHIA DESIGNS
ARCHITECTURAL DESIGN FOR RESIDENTIAL AND SMALL COMMERCIAL PROJECTS

Revisions	Date	Drwn
1 ISSUED FOR STRUCTURAL REVIEW	JUN.10/26	PLV
2		

Sheet Tile: CROSS SECTION A–A
Scale: 3/16"=1'–0"
Drawn by: PLV.
Checked by:
Date: JUNE/ 2026
Client:
Project Location: 149 GLEDHILL AVENUE TORONTO, ONTARIO

TORONTO Building RECEIVED 21/Jul/2026